

# FINAL/AS-BUILT – Subsurface Sewage Disposal




**Public Health**  
Prevent. Promote. Protect.  
Idaho Public Health Districts

**SOUTHWEST DISTRICT HEALTH**  
13307 Miami Lane  
Caldwell, ID 83607 (208) 455-5400

Permit #: **001503**  
Date Rcvd: **7-1-2020**  
Parcel #: **37853013 B0**

Applicant's Name: **Deko Contracting**  
Owners Name: **Michael & Sandra Reed**  
Property Address: **27498 Freezeout Rd Caldwell 83607**  
Legal Description: Township: **5N** Range: **3W** Section: **15**  
Subdivision: Lot: **32** Block: **1** Size: (acres) **13.7**

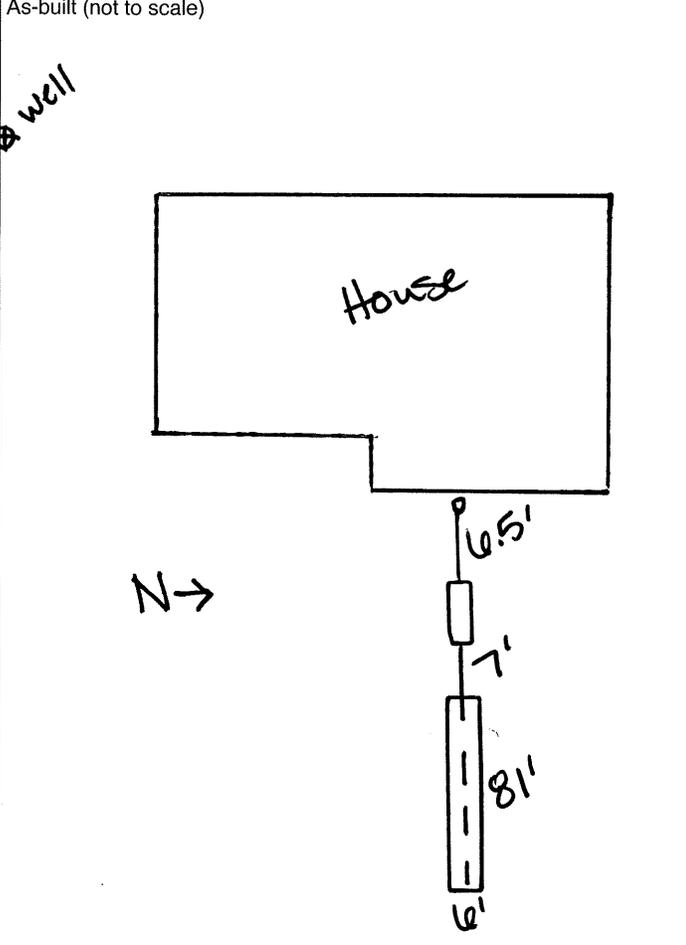

System Type:	Gravel (Yards):
<b>Gravel DF</b>	<b>18 yds Copes</b>
System Mfg:	Sand (Yards):
<b>N/A</b>	<b>18 yds "</b>
Septic/Trash Tank (Gal):	Installation Depth (Inches):
<b>1250</b>	<b>48"</b>
Septic/Trash Tank Mfr:	Rock Under Pipe (Inches):
<b>ECP</b>	<b>6"</b>
Depth to Tank Lid (Inches):	Date System Installed
<b>24"</b>	<b>10/22/2020</b>
Standpipe/Riser (Inches)	Riser Longitude:
<b>None</b>	<b>W 116° 40.913'</b>
Pump Tank (gallons):	Riser Latitude:
<b>None</b>	<b>N 43° 46.211'</b>
Pump Tank Mfg:	Well Installed
<b>N/A</b>	<input checked="" type="checkbox"/> Yes <input type="checkbox"/> No
Drainfield Width (Ft):	Distance to Tank (Ft):
<b>6'</b>	<b>116'</b>
Drainfield Length (Ft):	Distance to Drainfield (Ft):
<b>81'</b>	<b>121'</b>
Drainfield Area Installed (Sq Ft):	Valve: <input type="checkbox"/> Yes <input checked="" type="checkbox"/> No
<b>486</b>	Dist-Box: <input type="checkbox"/> Yes <input checked="" type="checkbox"/> No
Effective Area (Sq Ft):	Drop-Box: <input type="checkbox"/> Yes <input checked="" type="checkbox"/> No
<b>486</b>	

All plans, specifications, and conditions contained in the approved permit application are hereby incorporated into and may be enforceable as part of the permit.

Technical Allowance Granted  Yes  No  
Comments: **None**

Notes/Conditions of Approval: **None**

Installer Name: **Neuma Drain & Septic** Signature: **Not Available.**  
Installer Phone: **208-467-7100** Date:  
Installer Number: **1-1146**

By signing above, I certify that all answers and statements on this Final/As-built are true and complete to the best of my knowledge.  
OFFICIAL USE ONLY

As-Built provided by EHS  As-Built provided by Installer

DATE	<b>10/22/20</b>		
TRAVEL	<b>60</b>		
INSPECT	<b>45</b>		
EHS	<b>37</b>		

*Lise Bal*  
EHS Final Inspection Signature  
**37** **10/22/2020**  
EHS Code Date